


FOR PROPERTY LINE INFORMATION THIS PLAN RELIES ON DEEDS AND PLANS OF RECORD. THIS PLAN IS NOT REPRESENTED TO BE A TITLE EXAMINATION OR A RETRACEMENT SURVEY. THE SITE DOES NOT LIE WITHIN A FLOOD ZONE OF SPECIAL CONCERN PER FEMA FIRM 25027C0318E EFFECTIVE 7/4/2011.

AS-BUILT GARAGE PLAN

HARVARD, MASSACHUSETTS
PREPARED FOR: JOSHUA BRETZ



CIVIL ENGINEERS LAND SURVEYORS WETLAND CONSULTANTS
CORPORATE OFFICE: 1 MAIN STREET, SUITE 1 978-779-6091 100 MAIN ST., SUITE 310
LUNENBURG, MA 01462 www.dillisandroy.com CONCORD, MA 01742

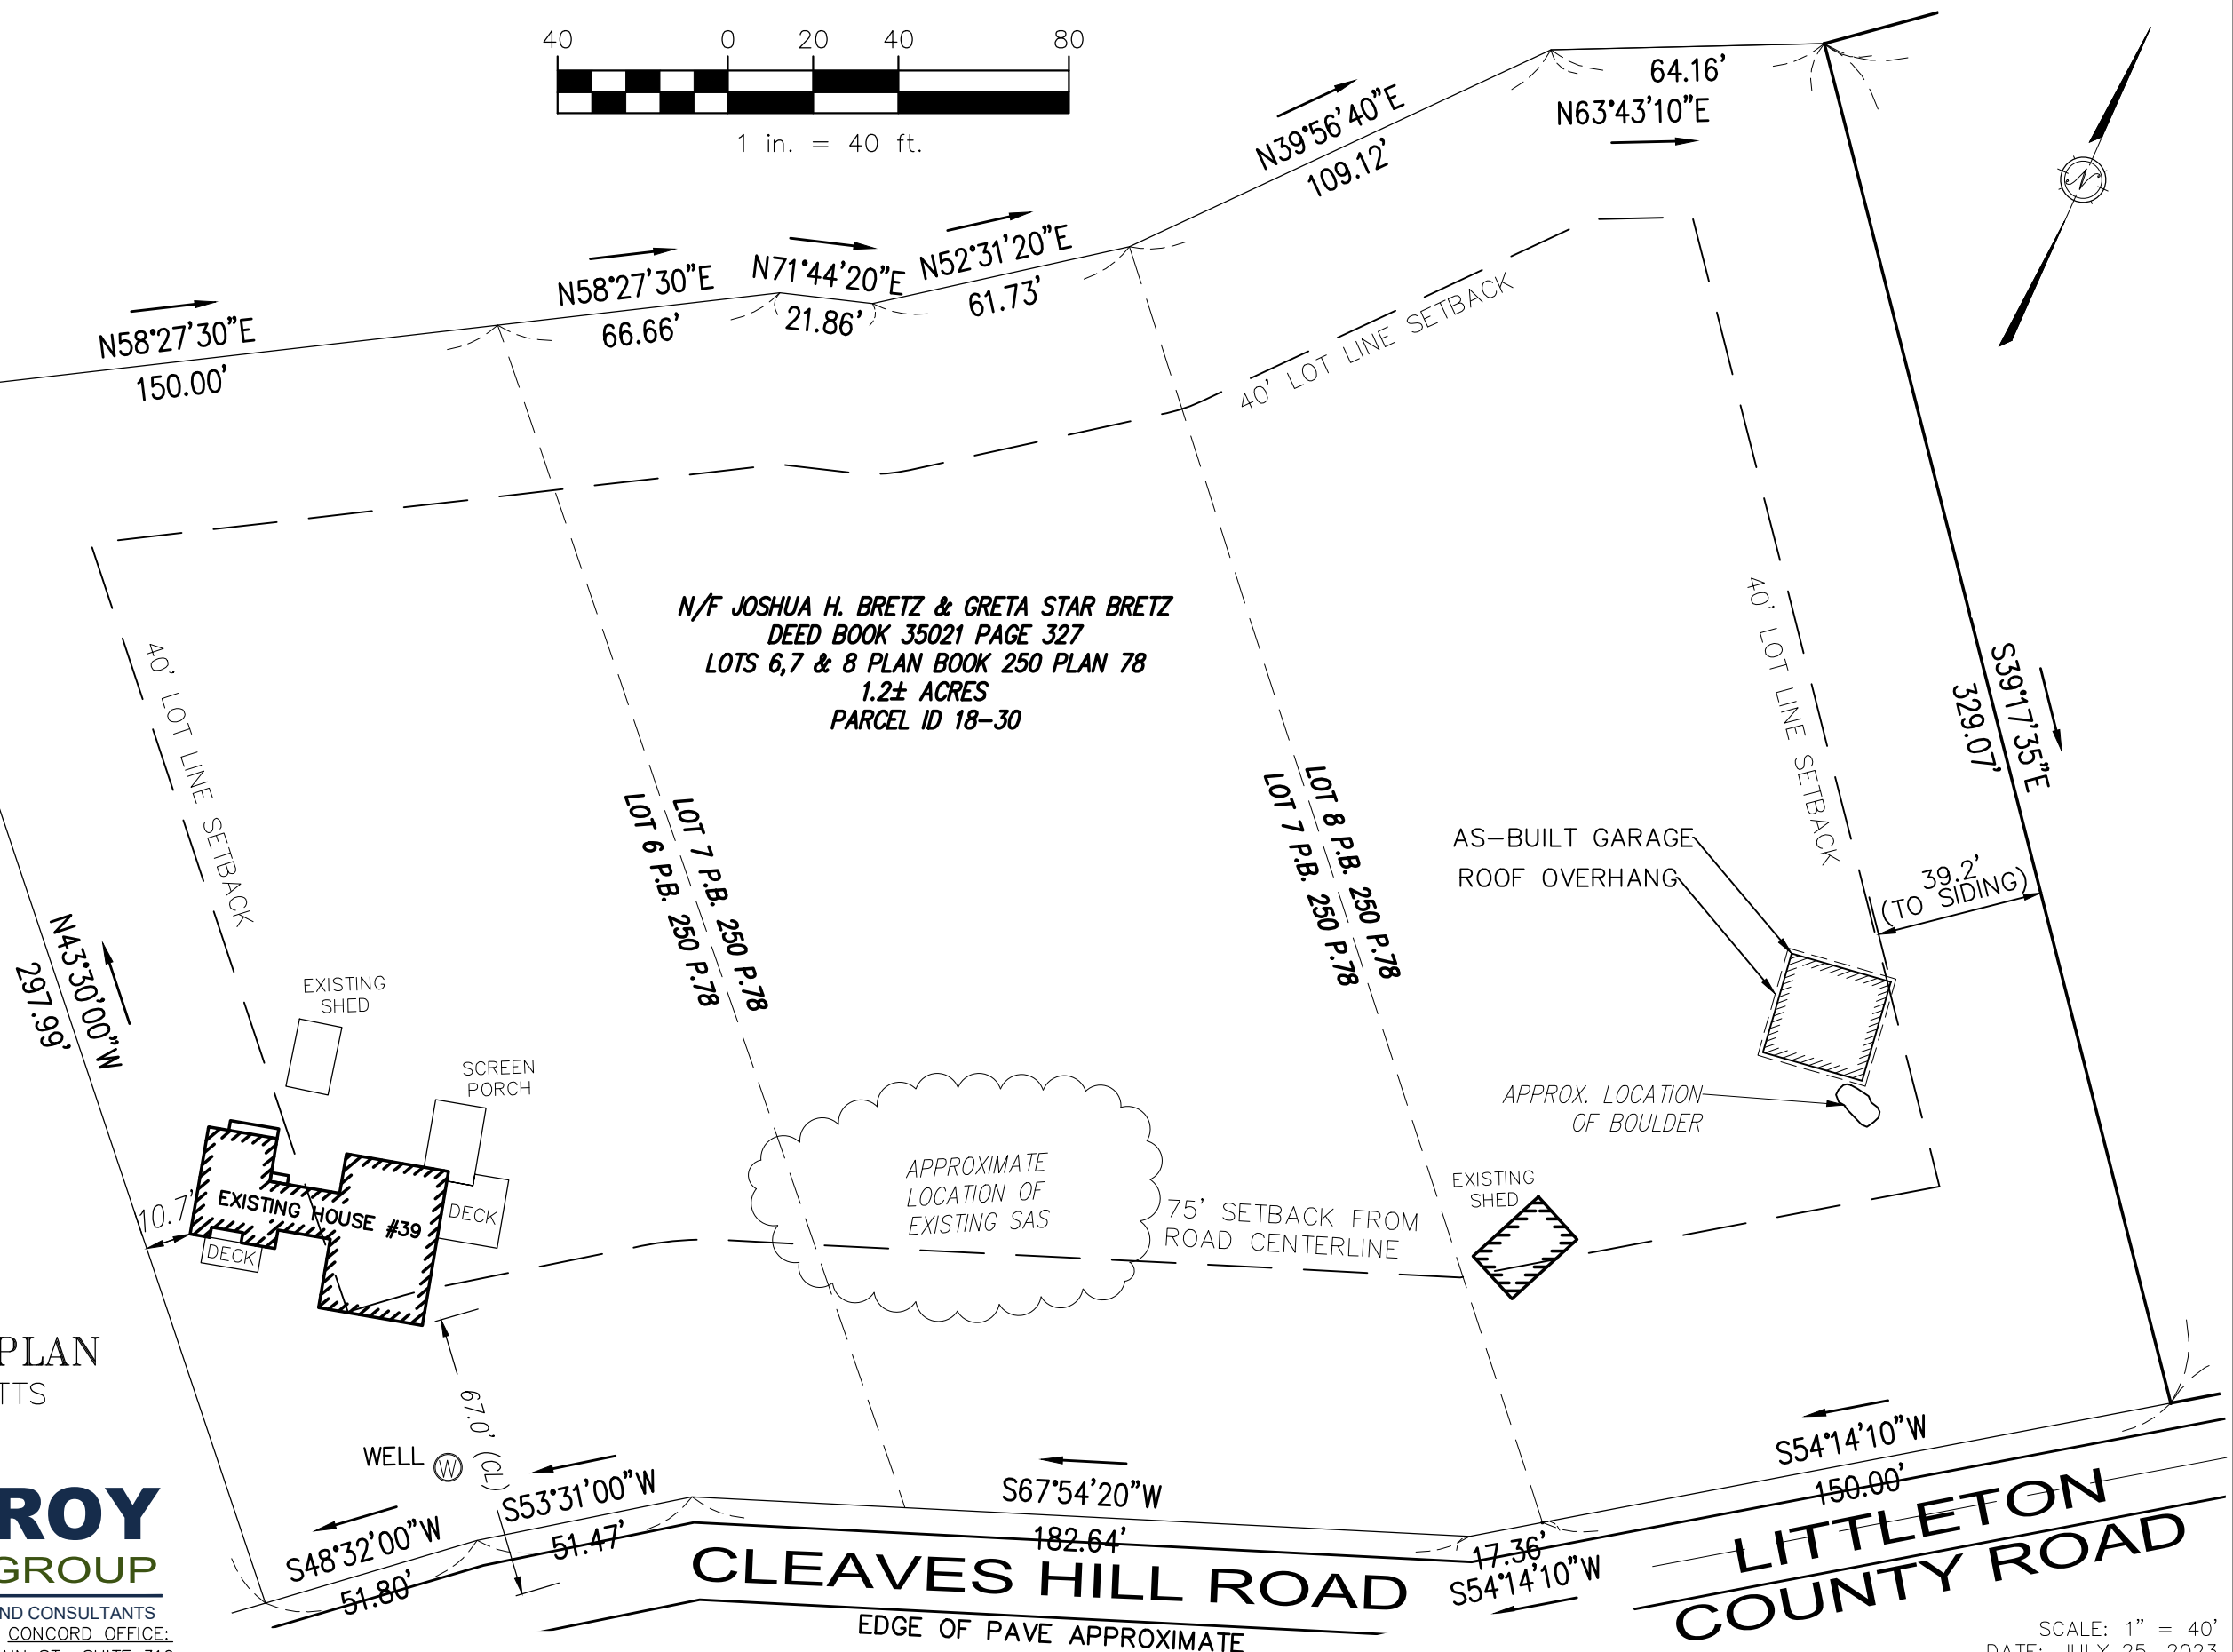

SCALE: 1" = 40'
DATE: JULY 25, 2023
FILE No.: 6772